



DESIGN SUMMARY


For

2023 Wilbur's Chocolate Factory

Version: As Built

Event Coordinator: Sam Carr

Layout Designer: Art Shean

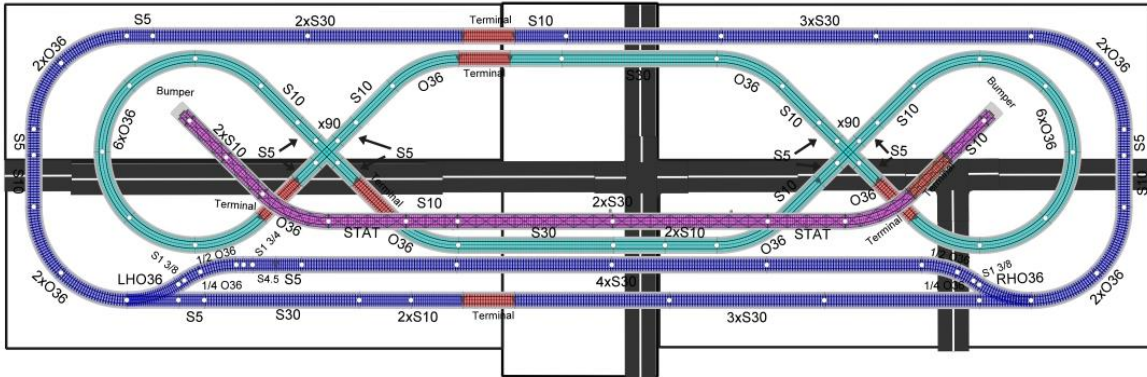

Location: 174 Lower Main Street, Freeport, ME 04032
Ran Trains: January 28, 10am-5pm & January 29, 10am-3pm
Dimensions: 5.5' x 18.5' with 2' x 4' Control Table, 109 square feet
Tables: 2 - 2.5' x 8', 2 - 3' x 8', 1 - 2.5' x 6', & 1 - 2' x 4'
Track: 109+' Lionel FasTrack – Two Separate Loops and an Elevated Trolley Line

6-12042, 0 Lionel FasTrack, Straight 30".	17
6-12014, 0 Lionel FasTrack, Straight 10".	17
6-12024, 0 Lionel FasTrack, Straight 5".	13
6-12025, 0 Lionel FasTrack, Straight 4 1/2".	1
6-12026, 0 Lionel FasTrack, Straight 1 3/4".	1
6-12073, 0 Lionel FasTrack, Straight 1 3/8".	3
6-84373, 0 Lionel FasTrack, Straight 15". Announcement Track	2
6-12016, 0 Lionel FasTrack, Terminal section 10".	7
6-12015, 0 Lionel FasTrack, Curve 18", angle 45° (O36)	26
6-12022, 0 Lionel FasTrack, Curve 18", angle 22.5° (O36)	2
6-12023, 0 Lionel FasTrack, Curve 18", angle 11.25° (O36)	2
6-12017, 0 Lionel FasTrack, Left turnout 10". (O36) (manual)	1
6-12018, 0 Lionel FasTrack, Right turnout 10". (O36) (manual)	1
6-12019, 0 Lionel FasTrack, Crossing 6". 90°	2
6-12059, 0 Lionel FasTrack, Buffer/Bumper 3 5/8".	2

Roads: 27.5' of 6" Wide Asphalt

