



DESIGN PACKAGE


For

2023 Moxie Festival

Version: As Built

Event Coordinator: Sam Carr

Layout Designer: Art Shean

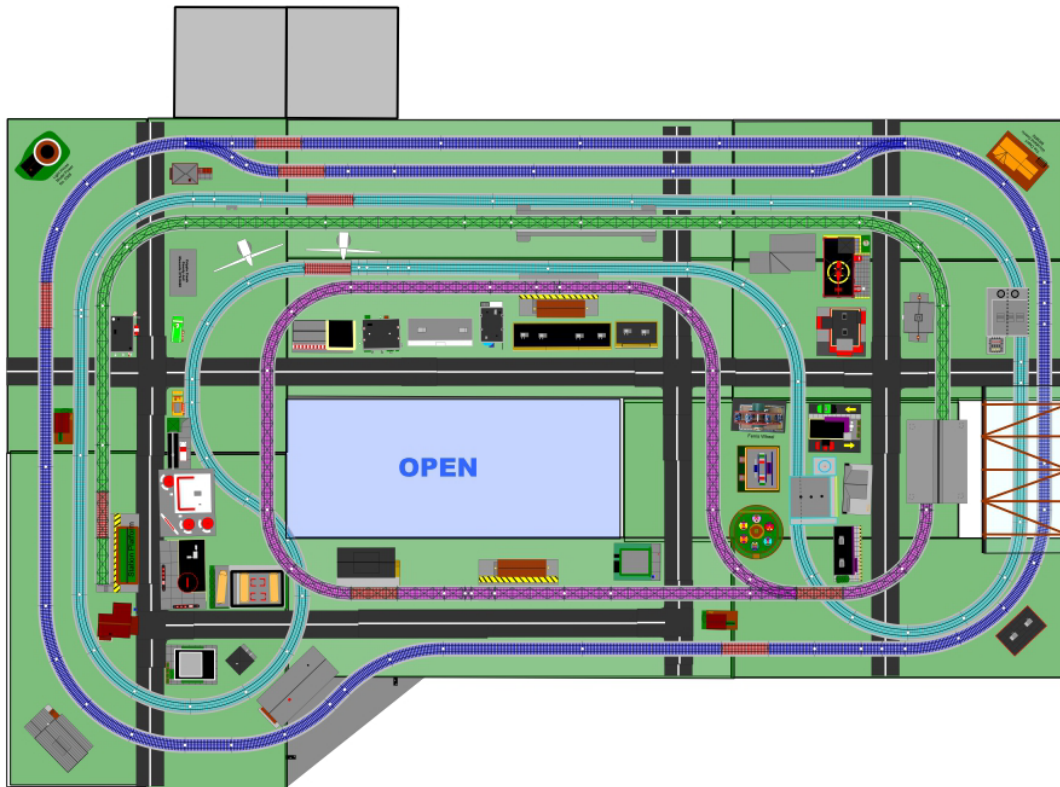

Track Required

6-12042, 0 Lionel FasTrack, Straight 30".	32
6-12014, 0 Lionel FasTrack, Straight 10".	16
6-12024, 0 Lionel FasTrack, Straight 5".	7
6-12025, 0 Lionel FasTrack, Straight 4 1/2".	9
6-12026, 0 Lionel FasTrack, Straight 1 3/4".	2
6-12073, 0 Lionel FasTrack, Straight 1 3/8".	2
6-84373, 0 Lionel FasTrack, Straight 15". Announcement Track	3
6-12016, 0 Lionel FasTrack, Terminal Section 10".	8
6-81314, 0 Lionel FasTrack, Block Lock-On Section 10". (Art)	1
6-12017, 0 Lionel FasTrack, Left turnout 10". (O36) (manual)	1
6-12018, 0 Lionel FasTrack, Right turnout 10". (O36) (manual)	2
6-12015, 0 Lionel FasTrack, Curve 18", angle 45° (O36)	13
6-12022, 0 Lionel FasTrack, Curve 18", angle 22.5° (O36)	2
6-12023, 0 Lionel FasTrack, Curve 18", angle 11.25° (O36)	3
6-12043, 0 Lionel FasTrack, Curve 24", angle 30° (O48)	28
6-12056, 0 Lionel FasTrack, Curve 30", angle 22.5° (O60)	20