




DESIGN SUMMARY

For 2023 Topsham Public Library

Version: R0

Event Coordinator: Sam Carr

Layout Designer: Art Shean

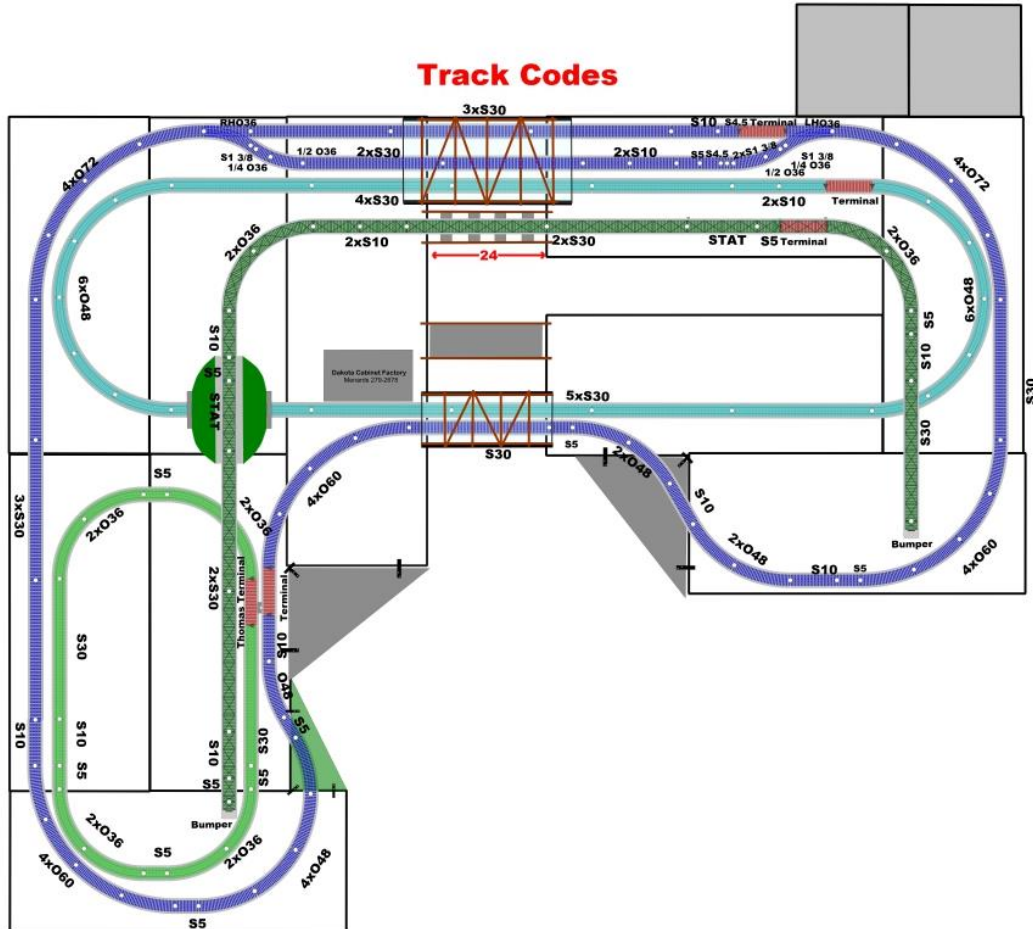

Location:	25 Foreside Road, Topsham, ME 04086
Run Trains:	February 24, 10am - 3pm
Dimensions:	14.5' x 18', 174 square feet
Tables:	9 - 2 1/2' x 6' Tables, 1-2 1/2' x 8' Table, & 1 - 2' x 4' Control Table
Track:	153+['] - Lionel FasTrack, 3 Independent Loops & 1 Elevated Trolley Line
6-12042, 0 Lionel FasTrack, Straight 30".	26
6-12014, 0 Lionel FasTrack, Straight 10".	15
6-12024, 0 Lionel FasTrack, Straight 5".	13
6-12025, 0 Lionel FasTrack, Straight 4 1/2".	2
6-12073, 0 Lionel FasTrack, Straight 1 3/8".	4
6-12016, 0 Lionel FasTrack, Terminal section 10".	4
6-37110, 0 Lionel FasTrack, Lion Chief Terminal section 10".	1
6-84373, 0 Lionel FasTrack, Straight 15". Announcement Track	2
6-12059, 0 Lionel FasTrack, Buffer/Bumper 3 5/8".	2
6-12015, 0 Lionel FasTrack, Curve 18", angle 45° (O36)	12
6-12022, 0 Lionel FasTrack, Curve 18", angle 22.5° (O36)	2
6-12023, 0 Lionel FasTrack, Curve 18", angle 11.25° (O36)	2

6-12043, 0 Lionel FasTrack, Curve 24", angle 30° (O48)	21
6-12056, 0 Lionel FasTrack, Curve 30", angle 22.5° (O60)	12
6-12041, 0 Lionel FasTrack, Curve 36", angle 22.5° (O72)	8
6-12017, 0 Lionel FasTrack, Left turnout 10". (O36) (manual)	1
6-12018, 0 Lionel FasTrack, Right turnout 10". (O36) (manual)	1

Bridges: 1- MTH 40-1070 Over/Under Tunnel, 1- Triple track 36" Wood Truss Bridge, 1- Dual track 28" Wood Truss Bridge, 1- Single track 28" Wood Girder Bridge, 1- 28" X 7" Street Girder Bridge, 2- 24"x30" Corner Fill, 1- 12'x24' Corner Fill, & 4 Lionel 6-12038 Elevated Trestle Sets

Roads: 37 feet of 6" Wide Asphalt

